

A

B

C

D

E

F

A

B


C

D

E

F

PRIMARY R.O DEVICE

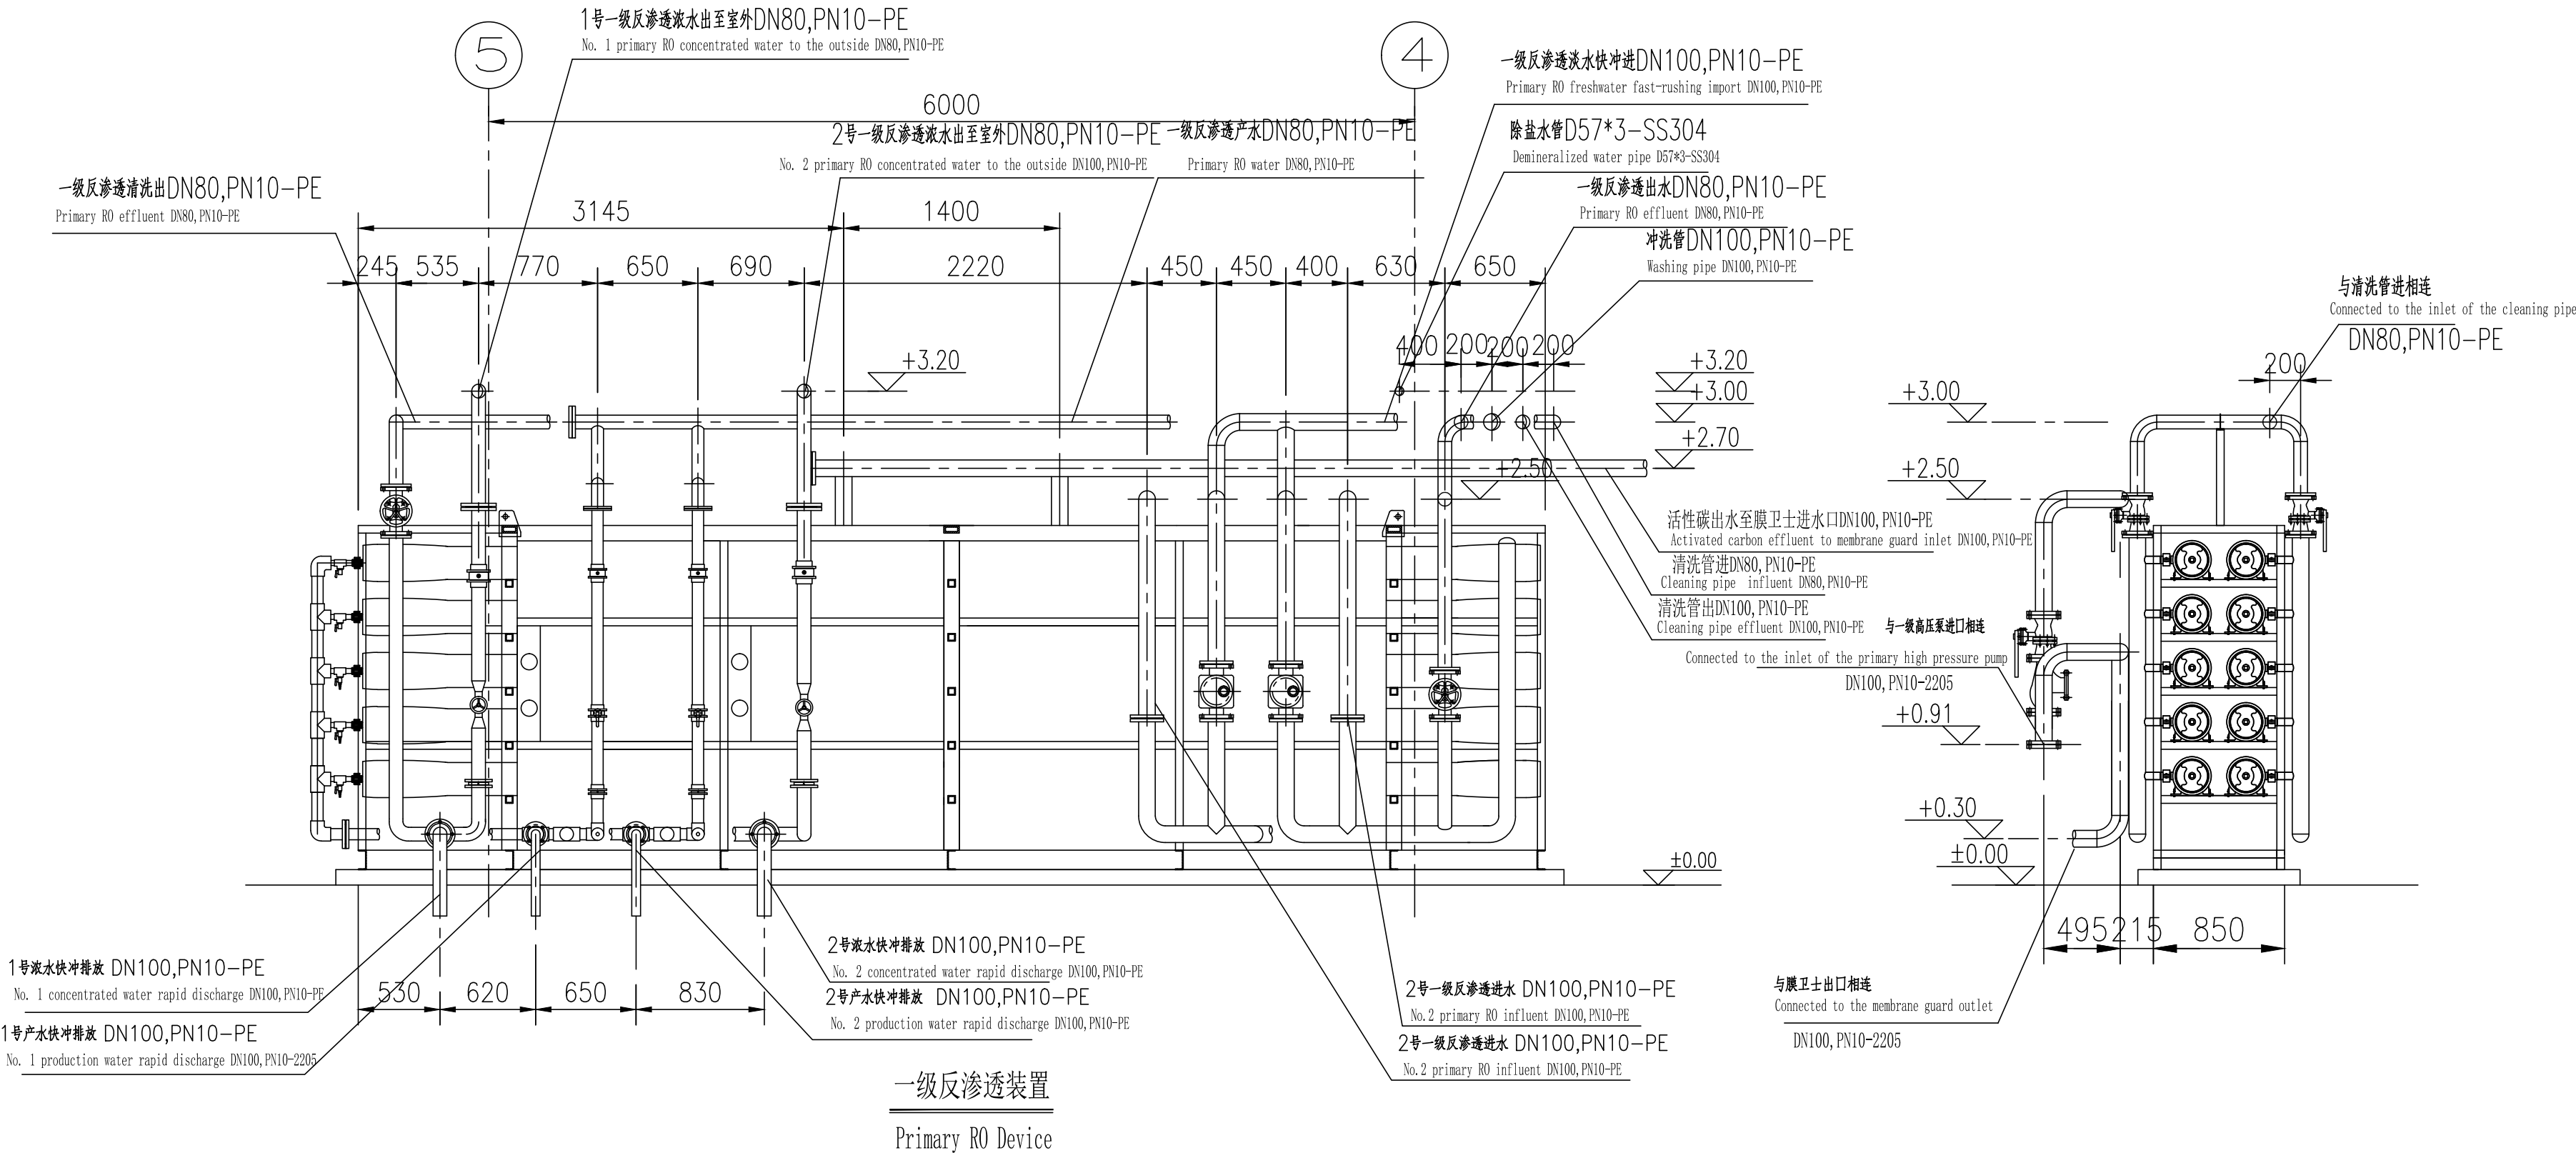

AS-BUILT DESIGN

COMMENT TYPE:

APPROVED

A



APPROVED WITH CORRECTIONS

B

RETURNED FOR CORRECTIONS

C

RECEIVED FOR INFORMATION

D

AS BUILT

SIG: 马强

DATE: 2023-06-21

I.T. (A) FOR APPROVAL (C) FOR CONSTRUCTION  
ISSUE TYPE (B) FOR INFORMATION (D) AS BUILT

0	D	AS BUILT		Sun Shujuan	Chen Ruizhen	Ma Jun
REV.	I.T.	DESCRIPTION	REVD	CHECKED	REVIEWED	APPROVED

OWNER:

DMCI POWER CORPORATION

EPC CONTRACTOR:



NORTHEAST NO.2 ELECTRICAL POWER CONSTRUCTION CO., LTD  
CHINA SOUTHEAST ASIA ELECTRIC POWER CONSTRUCTION CORP.

DESIGN INSTITUTE:



Shanghai Win-Energy Technology Co.,Ltd.

PROJECT:

1x15MW DMCI PALAWAN THERMAL POWER PLANT

	SIGN	DATE	DESIGN PHASE	AS BUILT
DESIGNED	孙强	2023-06-21	TITLE : 一级反渗透管道图 Pipeline diagram of primary RO	
DRAWN	孙强	2023-06-21		
CHECKED	孙海明	2023-06-21		
APPROVED	马强	2023-06-21	DRAWING NO.	SWDM-F202-H0201-05
SIZE:	SCALE :	Rev. 0		DPTPP-GCB-MID-H0201-05

SPECIALTY	COUNTERSIGN	DATE
A2+		

1

2

3

4

5

6

7

8

9

10