

A

B

C

D

E

F

A

B

C


D

E

F

MULTI-MEDIA FILTER

ACTIVATED CARBON FILTER

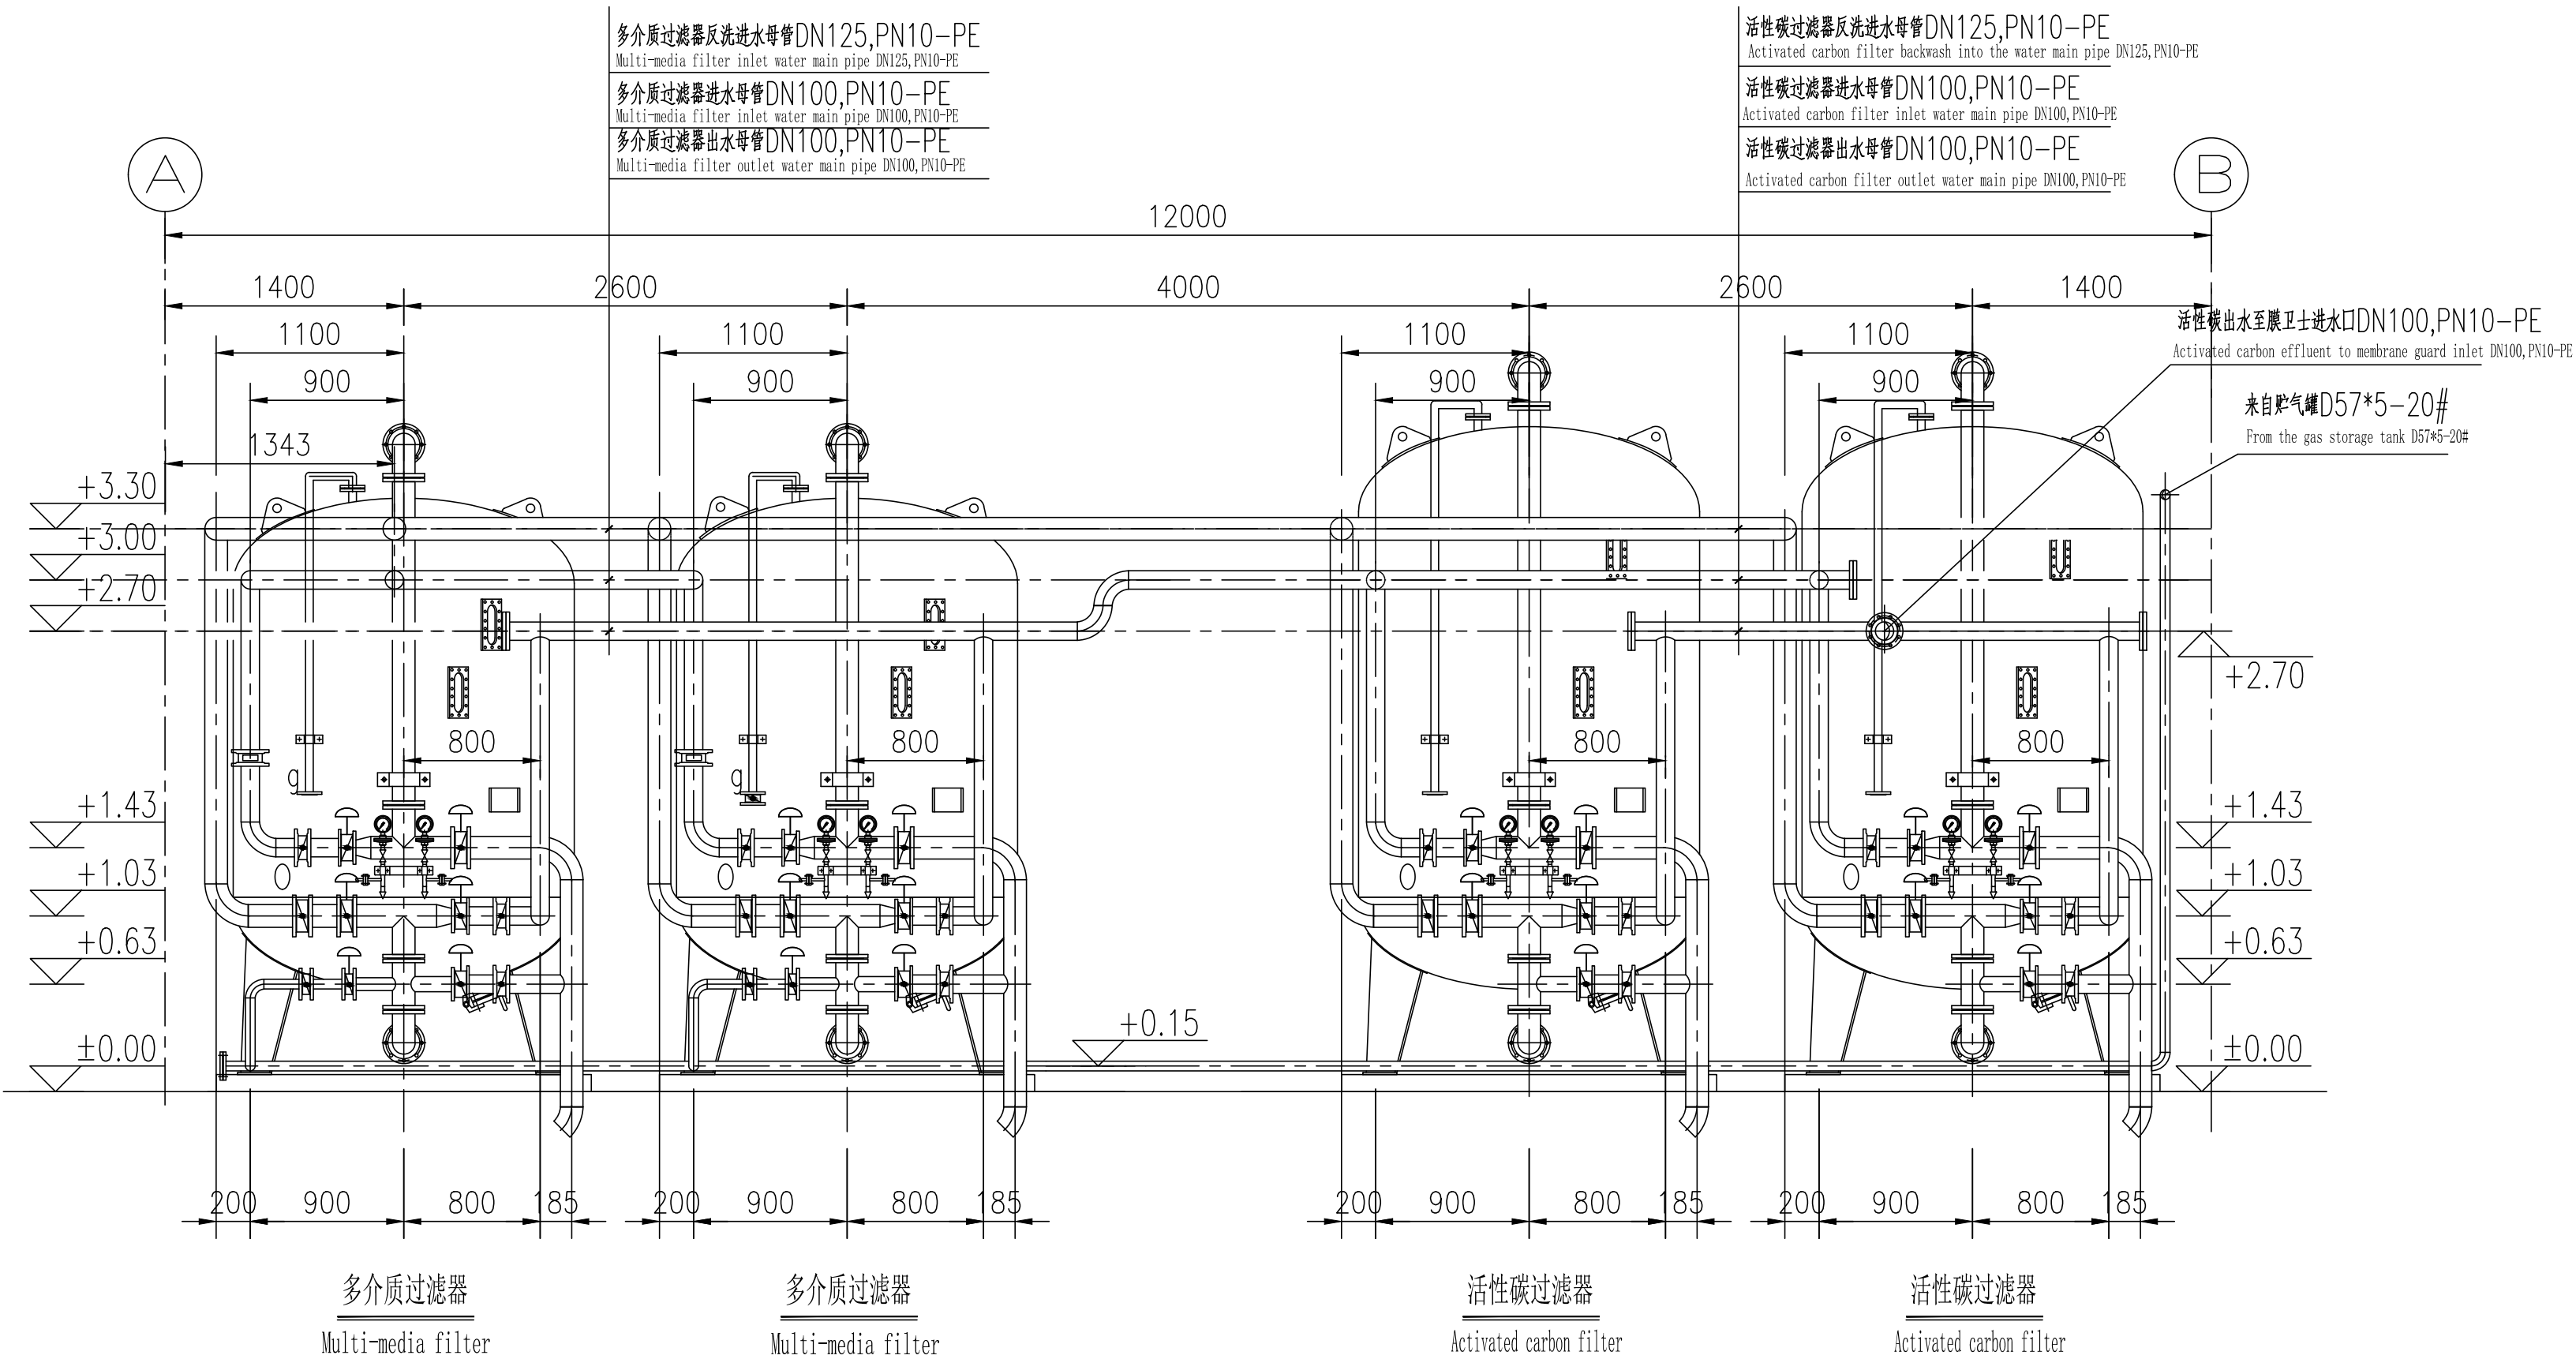

AS-BUILT DESIGN

COMMENT TYPE:

APPROVED	A	✓
APPROVED WITH CORRECTIONS	B	
RETURNED FOR CORRECTIONS	C	
RECEIVED FOR INFORMATION	D	

AS BUILT	
SIG: 马 强	DATE: 2023-06-21

I.T.		(A) FOR APPROVAL	(C) FOR CONSTRUCTION
ISSUE TYPE		(B) FOR INFORMATION	(D) AS BUILT
0	D	AS BUILT	Sun Shujuan Chen Ruizhen Ma Jun
REV.	I.T.	DESCRIPTION	REVD CHECKED REVIEWED APPROVED

OWNER:

DMCI POWER CORPORATION

EPC CONTRACTOR:



NORTHEAST NO.2 ELECTRICAL POWER CONSTRUCTION CO., LTD
CHINA SOUTHEAST ASIA ELECTRIC POWER CONSTRUCTION CORP.

DESIGN INSTITUTE:



Shanghai Win-Energy Technology Co.,Ltd.

PROJECT:

1x15MW DMCI PALAWAN THERMAL POWER PLANT

	SIGN	DATE	DESIGN PHASE	AS BUILT
DESIGNED	孙 强	2023-06-21	TITLE : 过滤器立面管道图 Filter facade pipe diagram	
DRAWN	孙 强	2023-06-21		
CHECKED	孙 强	2023-06-21		
APPROVED	马 强	2023-06-21	DRAWING NO.	SWDM-F202-H0201-04
SIZE:	SCALE :	Rev.		DPTPP-GCB-MID-H0201-04
		0		

SPECIALTY	COUNTERSIGN	DATE
A2+		

1

2

3

4

5

6

7

8

9

10