CLARIFIER

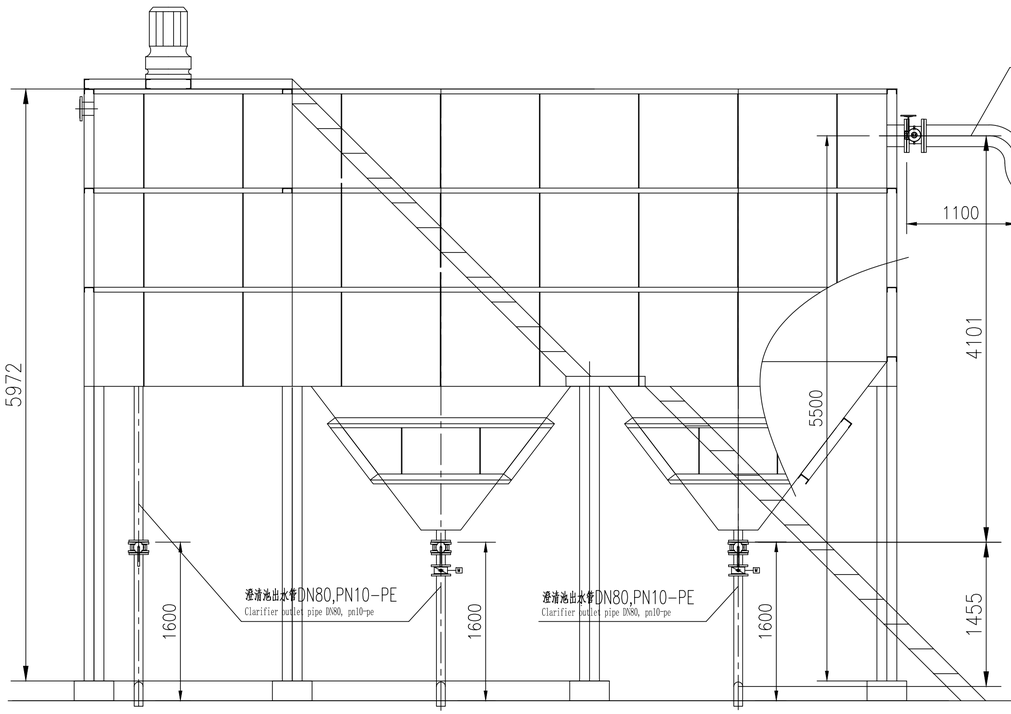

澄清池

Clarifier

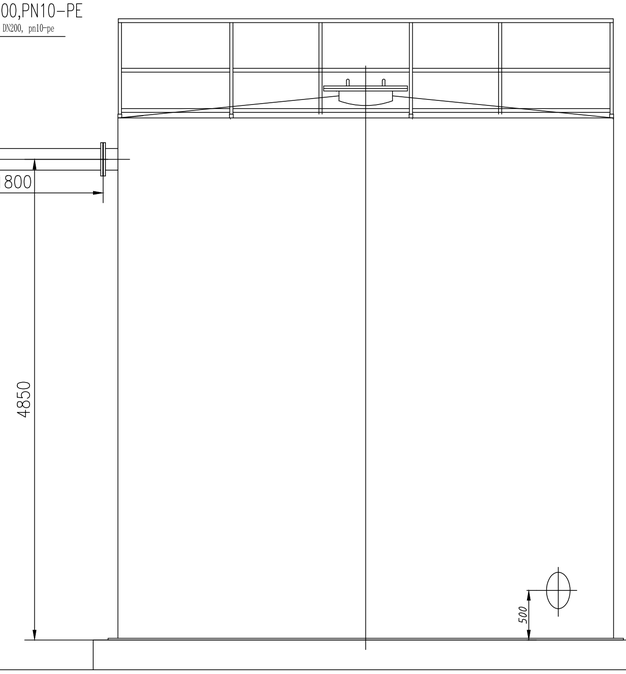

原水箱

Raw water tank

DMCI POWER CORPORATION

AS-BUILT DESIGN

COMMENT TYPE:

APPROVED	A	✓
APPROVED WITH CORRECTIONS	B	
RETURNED FOR CORRECTIONS	C	
RECEIVED FOR INFORMATION	D	

AS BUILT	
SIG: 马军	DATE: 2023-06-21

I.T.	(A) FOR APPROVAL	(C) FOR CONSTRUCTION
ISSUE TYPE	(B) FOR INFORMATION	(D) AS BUILT

REV.	I.T.	DESCRIPTION	REVD	CHECKED	REVIEWED	APPROVED
0	D	AS BUILT		Sun Shujuan	Chen Ruizhen	Ma Jun

OWNER:

DMCI POWER CORPORATION

EPC CONTRACTOR:

NORTHEAST NO.2 ELECTRICAL POWER CONSTRUCTION CO., LTD
CHINA SOUTHEAST ASIA ELECTRIC POWER CONSTRUCTION CORP.

DESIGN INSTITUTE:

Shanghai Win-Energy Technology Co.,Ltd.

PROJECT:

1x15MW DMCI PALAWAN THERMAL POWER PLANT

	SIGN	DATE	DESIGN PHASE	AS BUILT
DESIGNED	孙	2023-06-21	TITLE: 水力循环澄清池管道图 Pipeline diagram of Hydraulic circulating clarifier	
DRAWN	孙	2023-06-21		
CHECKED	孙海鹏	2023-06-21		
APPROVED	马军	2023-06-21	DRAWING NO.	SWDM-F202-H0201-02
SIZE: A2+	SCALE: 1:35	Rev. 0		DPTPP-GCB-MID-H0201-02

SPECIALTY	COUNTERSIGN	DATE